


SMITH'S CROSSING

PHASE 9 CITY OF SUN PRAIRIE DANE COUNTY, WISCONSIN

BENCHMARKS	
Top of Hydrant at O'Keeffe Avenue & Wild Iris Street	949.29
Top of Hydrant at O'Keeffe Avenue & Brown Bear Way	952.65
Top of Hydrant at O'Keeffe Avenue & Jenny Wren Trail	953.87

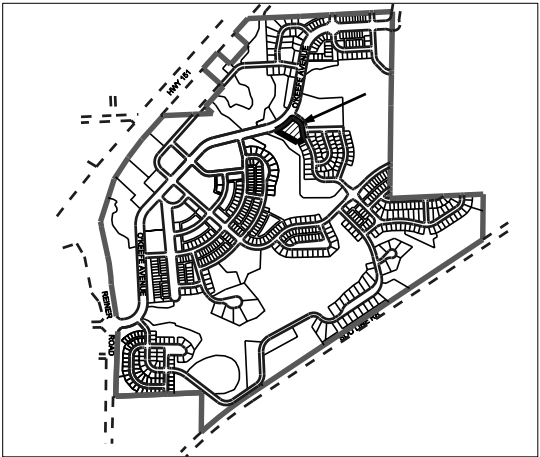

PROJECT LOCATION



D'ONOFRIO KOTTKE AND ASSOCIATES, INC.

7530 Westward Way, Madison, WI 53717
Phone: 608.833.7530 • Fax: 608.833.1089
YOUR NATURAL RESOURCE FOR LAND DEVELOPMENT

INDEX OF PAGES

- 1 COVER SHEET
- 2 SITE GRADING AND EROSION CONTROL
- 3 BROWN BEAR WAY PLAN/PROFILE

RECORD DRAWINGS

GENERAL CONTRACTOR: RAWSON CONTRACTORS

SUBCONTRACTORS: WOLFE PAVING
RAYMOND P. CATTELL
MOLL CONSTRUCTION

WORKED PERFORMED: UTILITY CONSTRUCTION: 11/15/10 - 11/19/10
PAVEMENT PATCHING: 11/19/10
REPAVING BROWN BEAR WAY: 6/11

PIPE MATERIAL: SANITARY LATERAL - SDR 35 PVC
STORM SEWER - RCP
WATER SERVICE - COPPER

BY: ERIN SALMON

FN: 10-05-130

**ISSUE DATE: 09-22-10
(AS BUILTS 01-25-11)**

SHEET 1 OF 3

DATE: 09-22-10
REVISED:
10-20-10
AS BUILT 1-25-11

DRAWN BY: DND

FN: 10-05-130


Sheet Number:
1 of 3

Cover Sheet

Smith's Crossing - Phase 9



City of Sun Prairie, Dane County, Wisconsin

D'ONOFRIO KOTTKE AND ASSOCIATES, INC.
7530 Westward Way, Madison, WI 53717
Phone: 608.833.7530 • Fax: 608.833.1089
YOUR NATURAL RESOURCE FOR LAND DEVELOPMENT

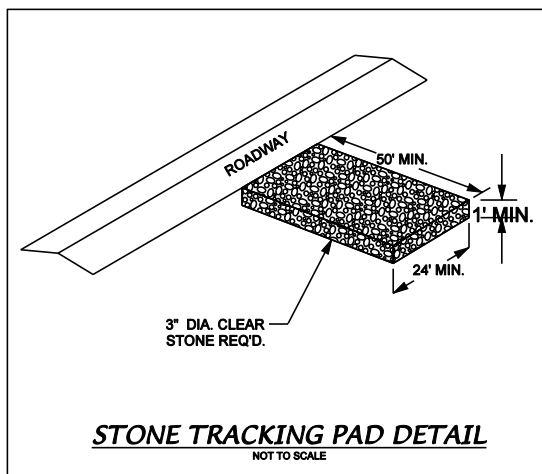

LEGEND

X	EXISTING TREE TO BE REMOVED
— 940 —	PROPOSED INDEX CONTOUR
— 942 —	PROPOSED INTERMEDIATE CONTOUR
- - - - -	PROPOSED LIMITS OF DISTURBANCE
- - - - -	SOIL SURVEY BOUNDARY LIMITS
- - - - -	SOIL SURVEY SOIL TYPE

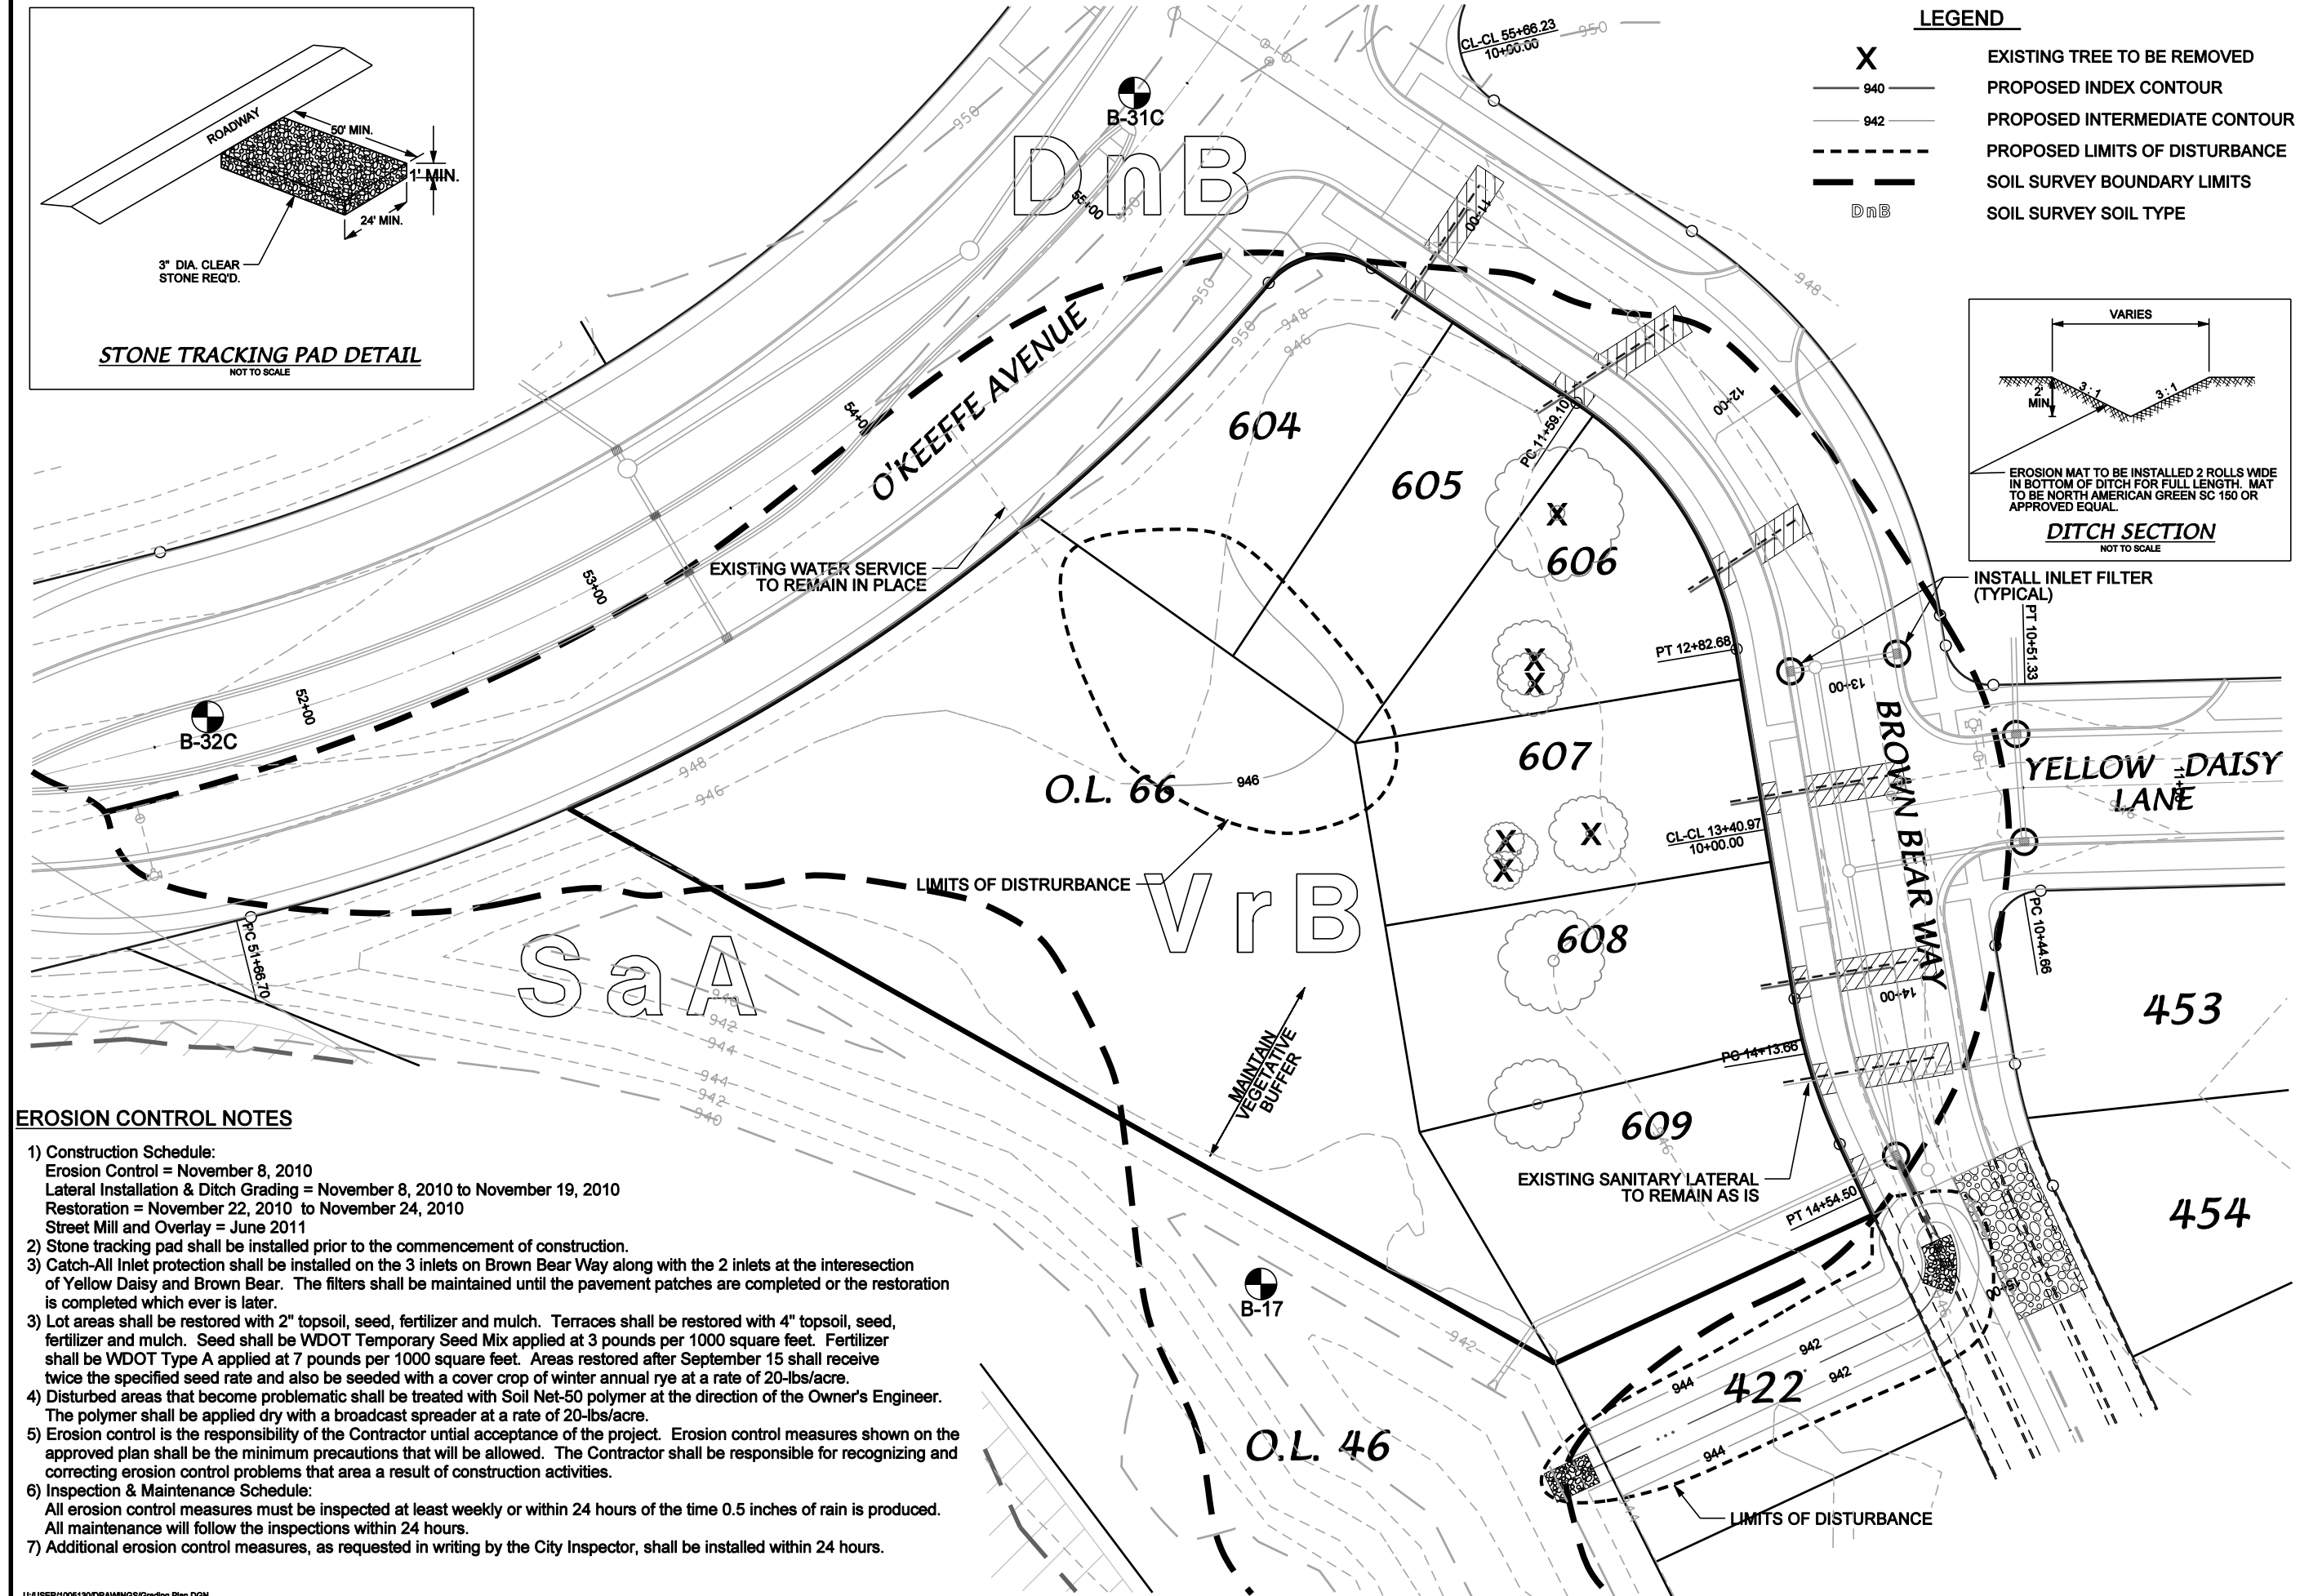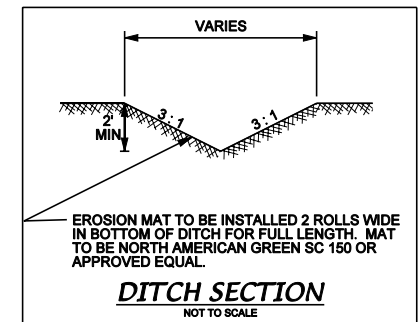

EROSION CONTROL NOTES

- Construction Schedule:
Erosion Control = November 8, 2010
Lateral Installation & Ditch Grading = November 8, 2010 to November 19, 2010
Restoration = November 22, 2010 to November 24, 2010
Street Mill and Overlay = June 2011
- Stone tracking pad shall be installed prior to the commencement of construction.
- Catch-All Inlet protection shall be installed on the 3 inlets on Brown Bear Way along with the 2 inlets at the intersection of Yellow Daisy and Brown Bear. The filters shall be maintained until the pavement patches are completed or the restoration is completed which ever is later.
- Lot areas shall be restored with 2" topsoil, seed, fertilizer and mulch. Terraces shall be restored with 4" topsoil, seed, fertilizer and mulch. Seed shall be WDOT Temporary Seed Mix applied at 3 pounds per 1000 square feet. Fertilizer shall be WDOT Type A applied at 7 pounds per 1000 square feet. Areas restored after September 15 shall receive twice the specified seed rate and also be seeded with a cover crop of winter annual rye at a rate of 20-lbs/acre.
- Disturbed areas that become problematic shall be treated with Soil Net-50 polymer at the direction of the Owner's Engineer. The polymer shall be applied dry with a broadcast spreader at a rate of 20-lbs/acre.
- Erosion control is the responsibility of the Contractor until acceptance of the project. Erosion control measures shown on the approved plan shall be the minimum precautions that will be allowed. The Contractor shall be responsible for recognizing and correcting erosion control problems that area a result of construction activities.
- Inspection & Maintenance Schedule:
All erosion control measures must be inspected at least weekly or within 24 hours of the time 0.5 inches of rain is produced.
All maintenance will follow the inspections within 24 hours.
- Additional erosion control measures, as requested in writing by the City Inspector, shall be installed within 24 hours.

Site Grading & Erosion Control Plan

Smith's Crossing - Phase 9

City of Sun Prairie, Dane County, Wisconsin

D'ONOFRIO KOTTE AND ASSOCIATES, INC.
7530 Westward Way, Madison, WI 53717
Phone: 608.833.7530 • Fax: 608.833.1089
YOUR NATURAL RESOURCE FOR LAND DEVELOPMENT



SCALE: 1" = 50'
(PAGE SIZE: 11x17)
0 25

DATE: 09-22-10
REVISED:
10-20-10
AS BUILT 01-25-11

DRAWN BY: DND

FN: 10-05-130

Sheet Number:
2 of 3

